

Georgia Department of Human Resources
INDIVIDUAL SEWAGE DISPOSAL SYSTEM INSPECTION REPORT

County Code 029 2 3 4	Construction Permit 9049 5 6 7 8	Case Number (FHA, VA, etc.) 9 10 11 12 13 14 15 16 17 18 19 20	Health Dist. NE 21 22	Day 08 23 24	Month 5 25 26	Year 79 27 28
------------------------------------	---	---	------------------------------------	---------------------------	----------------------------	----------------------------

Property Location Lot # 5 Block "C" 150 Albany Ct Cedar Shoals Estates #10	Property Owner Richard Marbut Contractor Sewage Disposal Contractor Kimsey Huff	County Clarke
--	---	-------------------------

ALL ITEMS: Blank = Not Applicable; 0 = Unknown

*ITEMS: 1 = Yes; 2 = No

SECTION A - GENERAL

1. Type Water Supply: (1) Public, (2) Community, (3) Indiv.	1
2. Financial Assistance: (1) FHA, (2) VA, (3) Farmers Home, (4) Conventional, (5) Other	4
3. House Structure: (1) New, (2) Existing < 1 year, (3) Existing > 1 year	1
4. Sewage Disposal Installation: (1) New, (2) Repair to existing sys.	1
5. If Repair of Existing System - Years System Installed: (1) < 1 year, (2) 1 - 2, (3) 2 - 3, (4) 3 - 5, (5) 5 - 10, (6) > 10	0
6. Percolation Rate Min./In.:	45
7. *Is Property Part of a Subdivision:	1

SECTION B - FACILITY

1. **Type Facility: See Code Below	02
2. Water Usage Determined by: (1) No. Bedrooms, (2) No. Gallons	1
3. Number Bedrooms or Gallons:	0004

SECTION C - LOT SIZE

1. Lot Depth (Average):	0175
2. Lot Width (Average):	0163
3. Building Line (Feet):	060

SECTION D - PRIMARY TREATMENT

1. Sewage Disposal Method: (1) Septic Tank, (2) Construction Privy, (3) Pit Privy, (4) Other	1
2. Septic Tank Capacity (gallons):	1500
3. Unit 1 Tank/Compartment Capacity:	1500
4. Septic Tank Inside Length (feet):	100
5. Septic Tank Inside Width (feet):	050
6. Septic Tank Liquid Depth (feet):	40
7. Septic Tank Material: (1) Precast concrete, (2) Poured in place, (3) Other	1
8. Dosing Tank Capacity (gallons):	000
9. Grease Trap Capacity (gallons):	000
10. Distance Septic Tank from Well:	000

SECTION E - SECONDARY TREATMENT


1. Field Layout Method: (1) Distribution Box, (2) Level Field, (3) Serial	1
2. Nitrification Field:	60
a. Total Square Feet	1200

b. Total Linear Feet	0400
c. Length each Trench (feet)	100
d. Width of Trenches (inches)	36
e. Number of Trenches	04
f. Distance between Trenches	10
g. Average Trench Depth (inches)	30
h. * Aggregate Proper Size	1
i. * Aggregate Proper Depth	1
j. Distance from Building Foundation	030
k. Nearest Property Line: (1) Front, (2) Rear, (3) R. Side, (4) L. Side	2
l. Distance Nearest Property Line	015
m. Distance Privy or Nitrification Field from Well	000

SECTION F - HEALTH AGENCY TIME

1. Total Inclusive Time (min.):	120
SECTION G - SYSTEM APPROVED	71 72 73
1. * Yes	1
2. No	1

Sketch

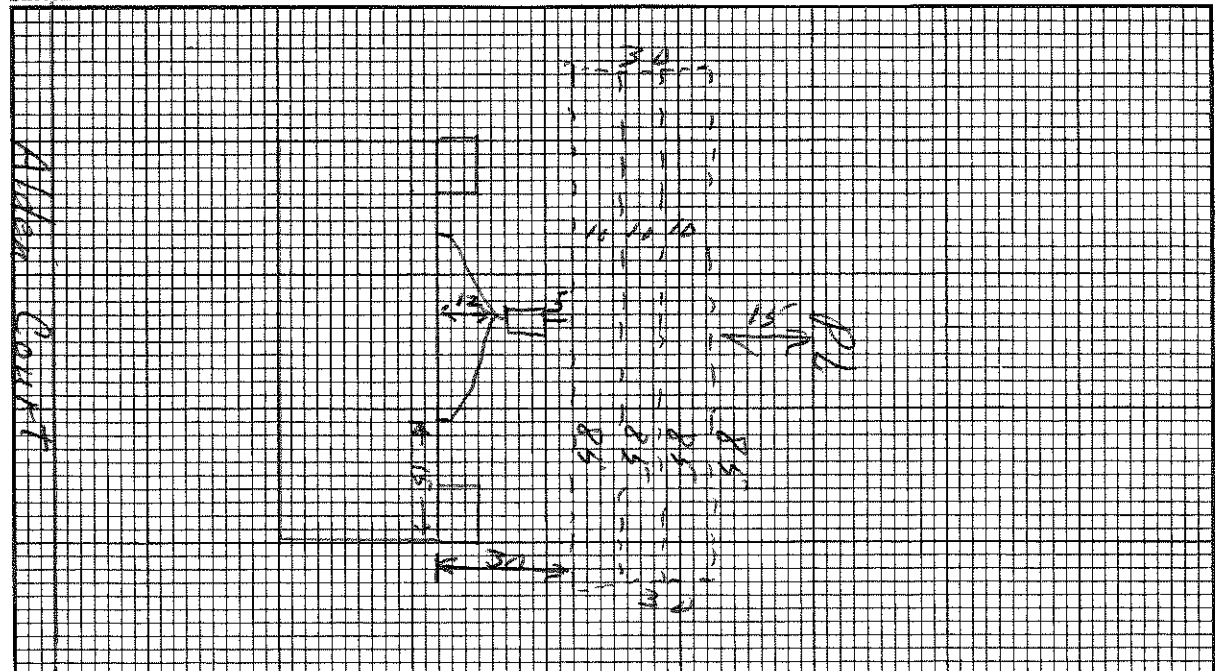

1. **Type Facility
- (1) Residence
 - (2) Apartment
 - (3) Institution
 - (4) Service Station
 - (5) Restaurant
 - (6) Church
 - (7) Tourist Accommodation
 - (8) Launderette
 - (9) Mobile Home Park
 - (10) Other (Specify) _____

Remarks: **Lot too low to go on City Sewage**

Inspected by: Shad P. Pirile	Title PHS	Health Agency Clarke Co.
--	---------------------	------------------------------------