

Georgia Department of Public Health

ON-SITE SEWAGE MANAGEMENT SYSTEM INSPECTION REPORT

CONSTRUCTION PERMIT NUMBER

09500365

COUNTY	COUNTY CODE	HEALTH DISTRICT	MONTH	DAY	YEAR
Madison	095	10	06	25	21
SUBDIVISION: Woodbury		LOT 23	PROPERTY OWNER: Reliant Homes GA LLC		
PROPERTY LOCATION / ADDRESS: 223 Manor Dr.			SEWAGE CONTRACTOR: Michael Sargent		
			CONTRACTOR LICENSE:		

ALL ITEMS: (BLANK) = Not Applicable (0) = Unknown *ITEMS (1) = Yes (2) = No

Section A - General	Section B - Primary / Pretreatment Section	Section C - Secondary Treatment
WATER SUPPLY: (1) Public (2) Private (3) Community	1. DISPOSAL METHOD: (1) Septic Tank (2) Privy (3) Aerobic Unit (4) Other:	1. ABSORPTION FIELD DESIGN (1) Level (2) Serial (3) Drip (4) Bed (5) Distribution Box (6) Mound (7) Other:
2. ** TYPE OF STRUCTURE: (See Below)	2. SEPTIC TANK: a. Capacity (gals):	2. ABSORPTION FIELD: a. Total square feet:
3. STRUCTURE AGE: (1) New (2) <1 Year (3) > 1 Year	b. Material: (1) Concrete (2) Polyethylene (3) Fiberglass (4) Poured (5) Other:	b. Total linear feet:
4. SEWAGE SYSTEM: (1) New (2) Repair (3) Addition	c. Distance from (feet): (1) Well: (2) Building: (3) Lake/Stream: (4) Nearest property line:	c. Number of trenches
5. AGE OF SYSTEM (repairs): (1) <1 (2) 1-5 (3) 6-10 (4) 11-20 (5) 21-30 (6) 31-40 (7) >40	d. Manufacturer: Infiltrator	d. Length trenches (feet):
6. * IN SUBDIVISION?:	3. FILTER MANUFACTURER/ MODEL: Tuf tite ef4	e. Distance between trenches (feet):
7. WATER USAGE BY: (1) Bedroom Numbers (2) Gallons Per Day	4. AEROBIC UNIT: a. Treatment capacity: b. Manufacturer:	f. Depth of trenches (range in inches):
8. NO. OF BEDROOMS/ GALLONS PER DAY:	5. DOSING TANK CAP (gals):	g. * Aggregate proper size:
9. LOT SIZE:	6. GREASE TRAP CAP (gals):	h. * Aggregate proper depth:
10. PERCOLATION/RATE/ LOADING RATE:		i. Distance from (feet) (1) Well: (2) Building: (3) Lake/Stream: (4) Nearest property line:
11. SOIL CLASSIFIER: Craig Canaday		j. Nearest property line: (1) Right (2) Left (3) Front (4) Rear
12. SOIL SERIES: Gwinnett		k. Product used: Infiltrator Quick 4 Plus

** TYPE OF FACILITY
(1) Single-Family Residence
(2) Multi-Family Residence
(3) Commercial ≤ 2000
(4) Commercial ≥ 2000
(5) Restaurant
(6) Mobile Home Park
(7) Other (specify)

REMARKS:
✓ Pump Liberty 281-5 1/2" HD
✓ Alarm

W806/30/21 FAXED


Drawing not to scale

Issuance of a construction permit for an on-site sewage management system, and subsequent approval of same by representatives of the County Board of Health shall not be construed as a guarantee that such systems will function satisfactorily for a given period of time; furthermore, said representatives do not, by any action taken in affecting compliance with these rules, assume any liability for damages which are caused, or which may be caused, by the malfunction of such system.

ENVIRONMENTALIST:

TITLE:

* SYSTEM APPROVED:
(see Sect. A7 & 8)

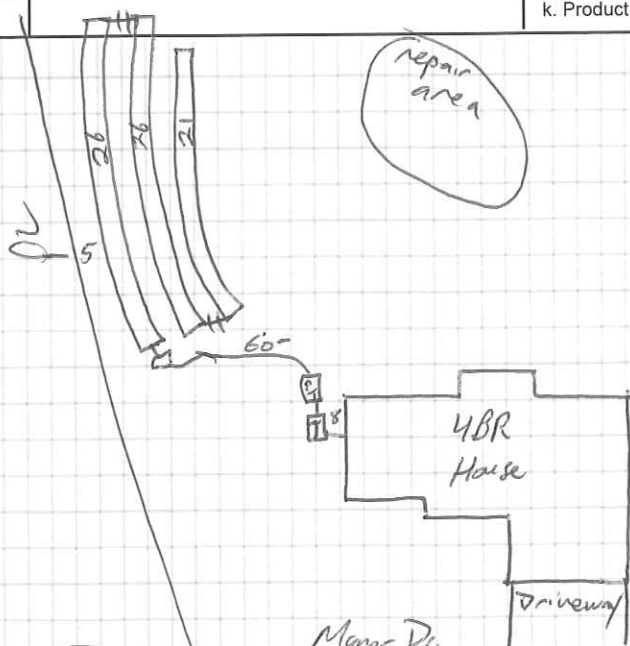

repair area

Manor Dr.

EHCM

1